



1835 Alexander Bell Dr

2nd Floor | As Built Plan

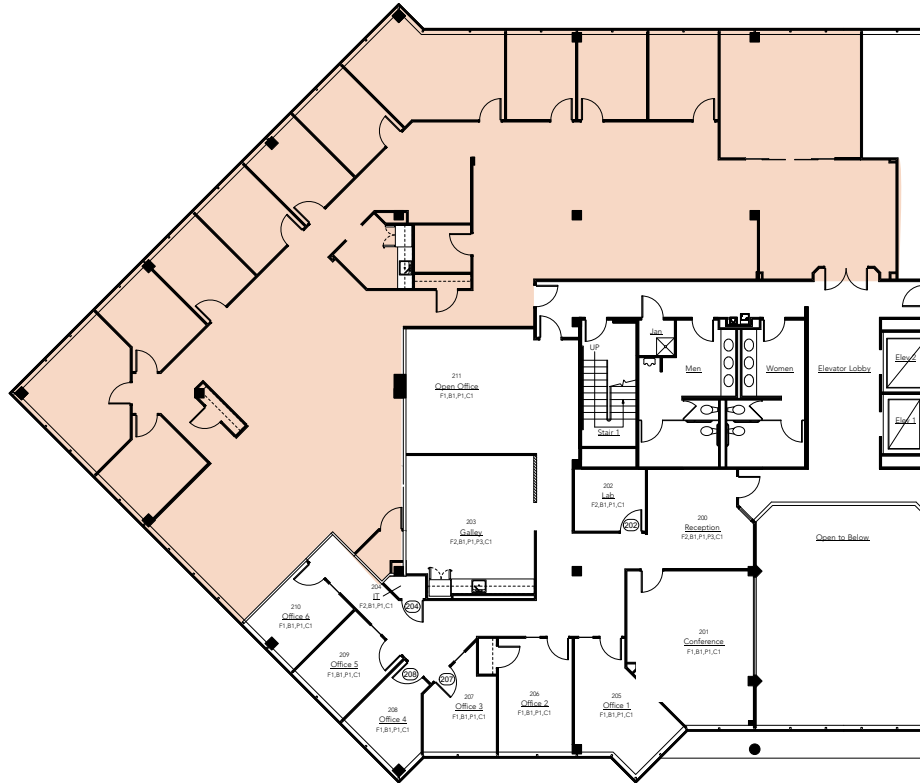

Suite 200 | 6,527 SF
Available Immediately

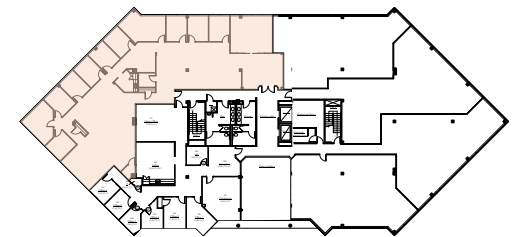

LEASING OPPORTUNITES: [703.522.4600](tel:703.522.4600)

STODDIE NIBLEY
NEIL ALT
BRENDA SOSA

snibley@lpc.com
nalt@lpc.com
bsosa@lpc.com




1835 Alexander Bell Dr

2nd Floor | Multi-Tenant Hypothetical Layout



3,472 SF & 3,055 SF
Available Immediately

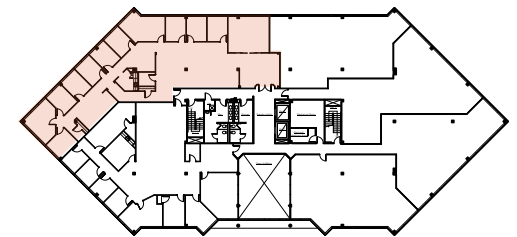

LEASING OPPORTUNITES: [703.522.4600](tel:703.522.4600)

STODDIE NIBLEY
NEIL ALT
BRENDA SOSA

snibley@lpc.com
nalt@lpc.com
bsosa@lpc.com

